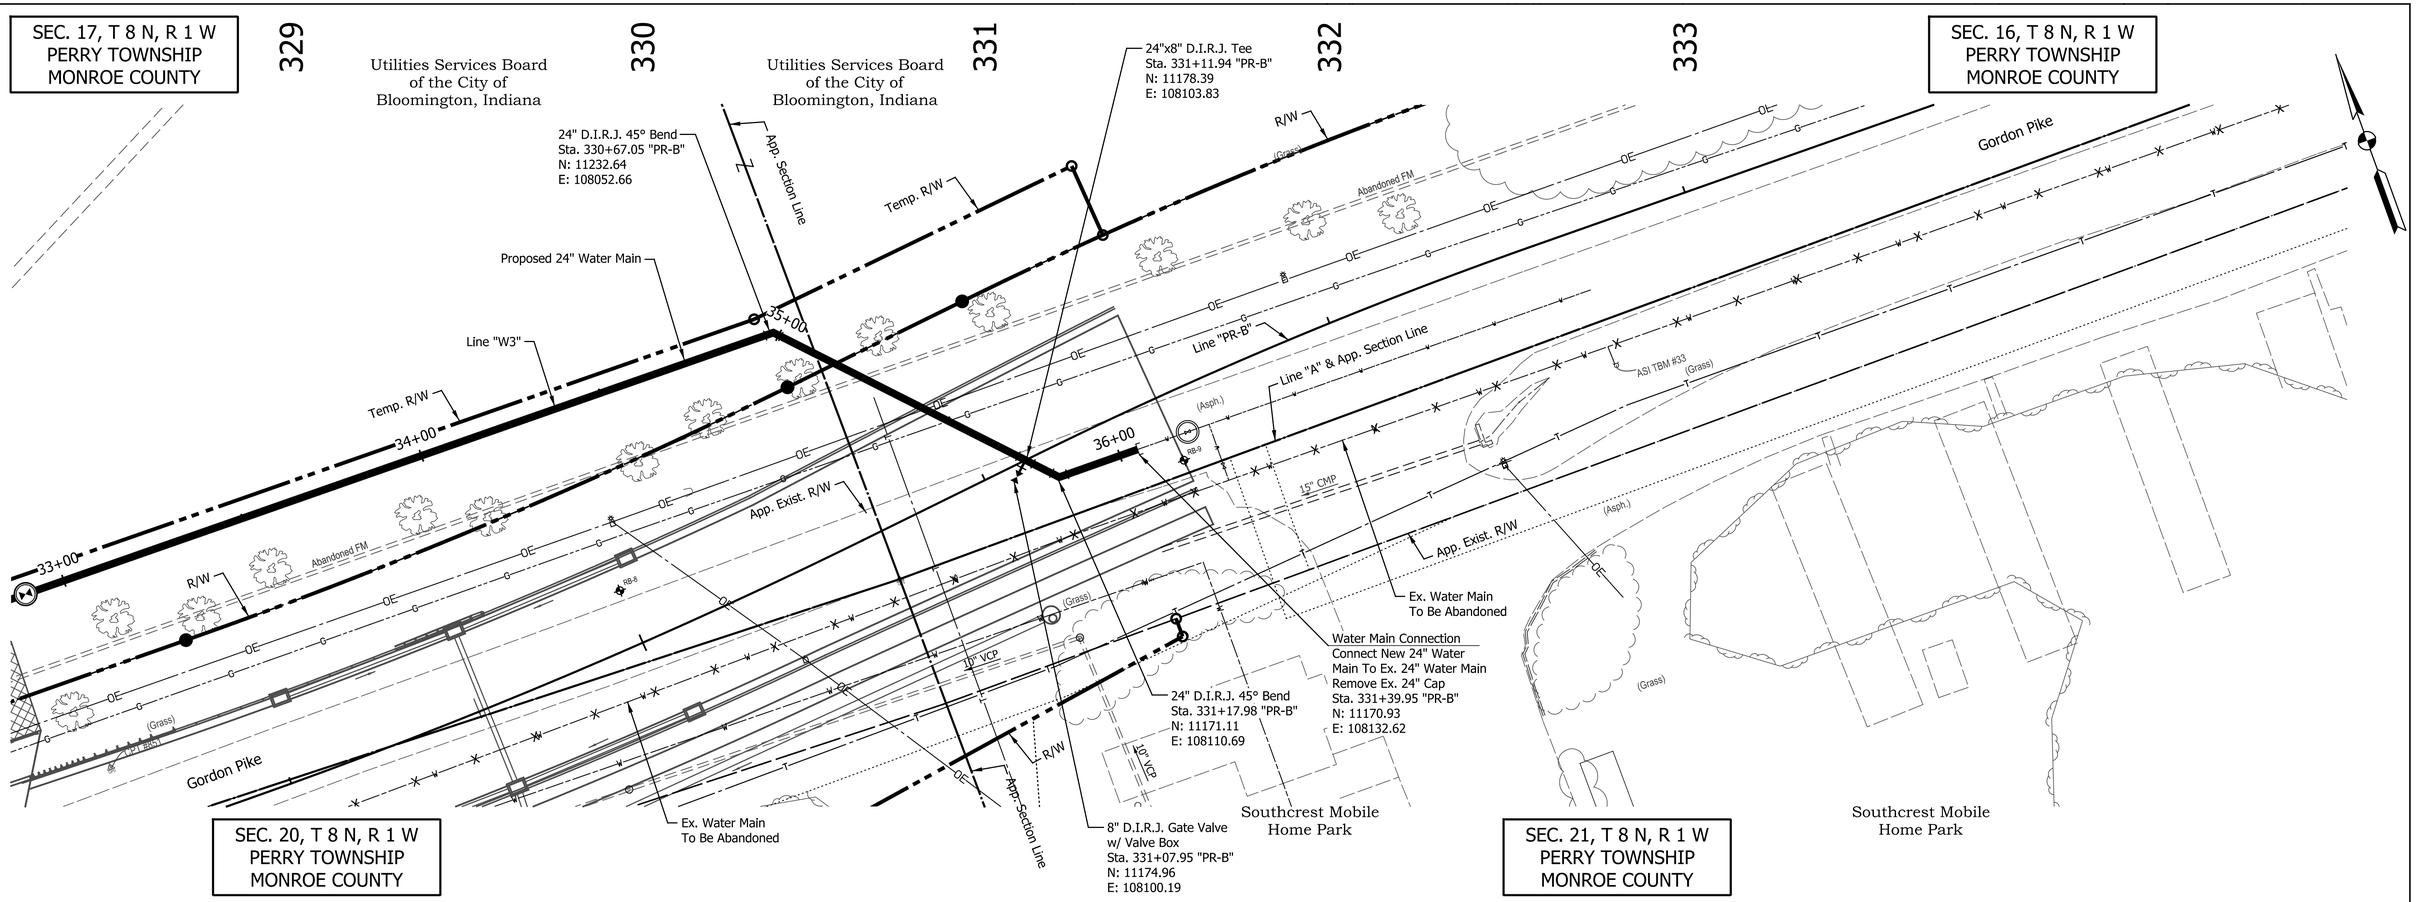

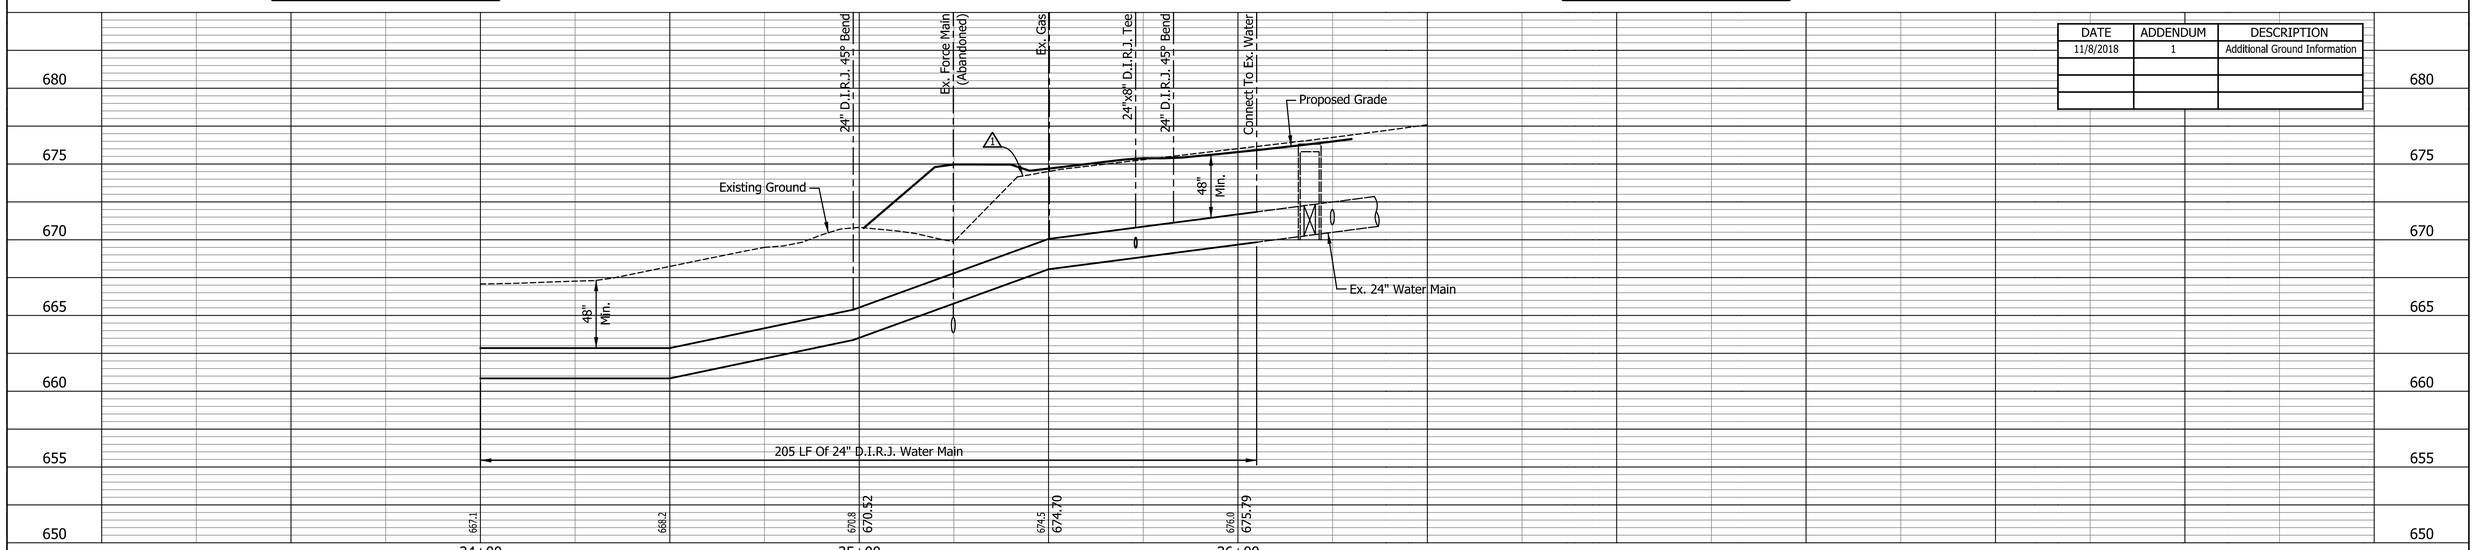

DATE	ADDENDUM	DESCRIPTION
11/8/2018	1	Additional Ground Information

NOTES:

1. Contractor Shall Field Verify All Existing Utilities And Report Any Discrepancies To The Engineer, Prior To Construction.
2. Station & Offset Shown On This Sheet Is Described From Line "PR-B", Unless Otherwise Noted.
3. See Standard Details For Additional Information.
4. The Minimum Cover Above Proposed Water Main Shall Be From Proposed Grade. Contractor Shall Be Responsible For Providing Sufficient Cover During Construction Activities To Prevent Damage To Pipes If Less Than 48" Until Final Fill And Grade Is Established.
5. Contractor Shall Be Responsible For Coordination w/ CBU For All Water Service And Active Water Main Connections.

LEGEND

X X X X X	Utility Abandonment Or Removal		Fire Hydrant		Fittings
	Valve		Cap		
	Butterfly Valve & Valve Vault		Reducer		
	Curb Stop		Water Main		
	Air Release Valve In MH	XX.X	Soil Boring		

D. ROBERT HENRICKSEN, JR. REGISTERED No. PE19600265 STATE OF INDIANA PROFESSIONAL ENGINEER

RECOMMENDED FOR APPROVAL: D. Robert Henricksen, Jr. 10/19/2018
DESIGN ENGINEER — DATE

DESIGNED: KMB | DRAWN: PJT
CHECKED: DRH | CHECKED: KMB

CITY OF BLOOMINGTON

PLAN AND PROFILE
WATER MAIN - LINE "W3"

HORIZONTAL SCALE	BRIDGE FILE
1" = 20'	N/A
VERTICAL SCALE	DESIGNATION
1" = 5'	N/A
SURVEY BOOK	SHEETS
N/A	15 of 21
CONTRACT	PROJECT
N/A	2016.02763

Indy-Prof.pltcfg
Indiana_Shad6.tbl

ptrawinski 11/8/2018 7:22:26 AM P:\IN2008\0807\D. Drawings\Environmental\IN20080807.UI.003.PP.W3.02.dgn